

604

Desoto County, Mississippi
~~160 Douglas Rd - Raines Res.~~ LINE WA 62358 FCA 360.2

RIGHT OF WAY INSTRUMENT

In consideration of \$1.00 cash, and other valuable considerations, receipt of all of which is hereby acknowledged, I/w (acting personally and for and on behalf of our heirs, successors, and assigns and any other person claiming or to claim the property herein after described, called collectively "Grantors") do hereby grant, convey and warrant unto MISSISSIPPI POWER & LIGHT COMPANY,

its successors and assigns (herein called "Grantee"), a right of way and easement 30 feet in width for the location construction, reconstruction, operation, maintenance, and removal of electric power and/or communications lines and circuits, including poles, towers, cross arms, insulators, wires, cables, hardware, transformers, switches, guy wires, anchors and all other equipment, structures, material and appliances, now or hereafter used, useful or desired in connection therewith, over, across, under, and on that land in the County of

Desoto, Mississippi, described as follows, to-wit:

Said easement is to be located on Grantor's property. Said property being located in the Southeast quarter of Section 34, Township 2 south Range 7 west, Desoto County, Mississippi. Easement is to be 15 feet each side of facilities as installed. Proposed location of said facilities is as shown in exhibit "A" attached.

together with the right of ingress and egress to and from said right of way across the adjoining land of the Grantors, the passage of vehicles and equipment upon said right of way and the right to install and maintain guy wires and anchors beyond the limits of said right of way.

Grantee shall have the full right, without further compensation, to clear and keep clear said right of way, including the right to cut down, condition, treat or otherwise remove all trees, timber, undergrowth, and other obstruction. Grantee shall have the further right to cut down from time to time all trees that are tall enough to strike the wires in falling, where located beyond the limits of said right of way, (called "danger trees"). Payment for the first cutting of danger trees is included in the above consideration. Grantee shall pay to Grantor, or his successor in title, the reasonable market value of danger trees cut thereafter.

Grantors covenant that they will not construct or permit the construction of any house, barn, well or other structure or hazard on said right of way.

Unless otherwise herein specifically provided, the center line of the electric power line initially constructed on this right of way shall be the center line of said right of way.

Should Grantee, or its successors, remove its facilities from said land and abandon said right of way, the rights herein created in Grantee shall terminate, but with the right to remove therefrom all of Grantee's property thereon.

It is understood that Grantors shall have, at all times the right to use said right of way for any lawful purpose provided it does not interfere with the rights herein created in Grantee, and that Grantee will not enclose said right of way, and Grantor will use the best effort to protect Grantee's property on said right of way.

WITNESS my/our signature, this the 7-22- day of 1991

Harold Raines

David L. Dent
STATE OF MISSISSIPPI
COUNTY OF DESOTO

Personally appeared before me, the undersigned authority in and for the above named jurisdiction, the within named DAVID L. DENT, one of the subscribing witnesses to the foregoing instrument, who being first duly sworn, deposeth and saith that he saw the within named HAROLD RAINES


and _____ whose names are subscribed thereto, sign and deliver the same to the said Mississippi Power & Light Company; that he, this affiant, subscribed his name as a witness thereto in the presence of the above named Grantors, and David L. Dent

Sworn to and subscribed before me, this the 10 day of September, 1991

My Commission Expires My Commission Expires March 2, 1994

David L. Dent
Notary Public
(Official Title)

50

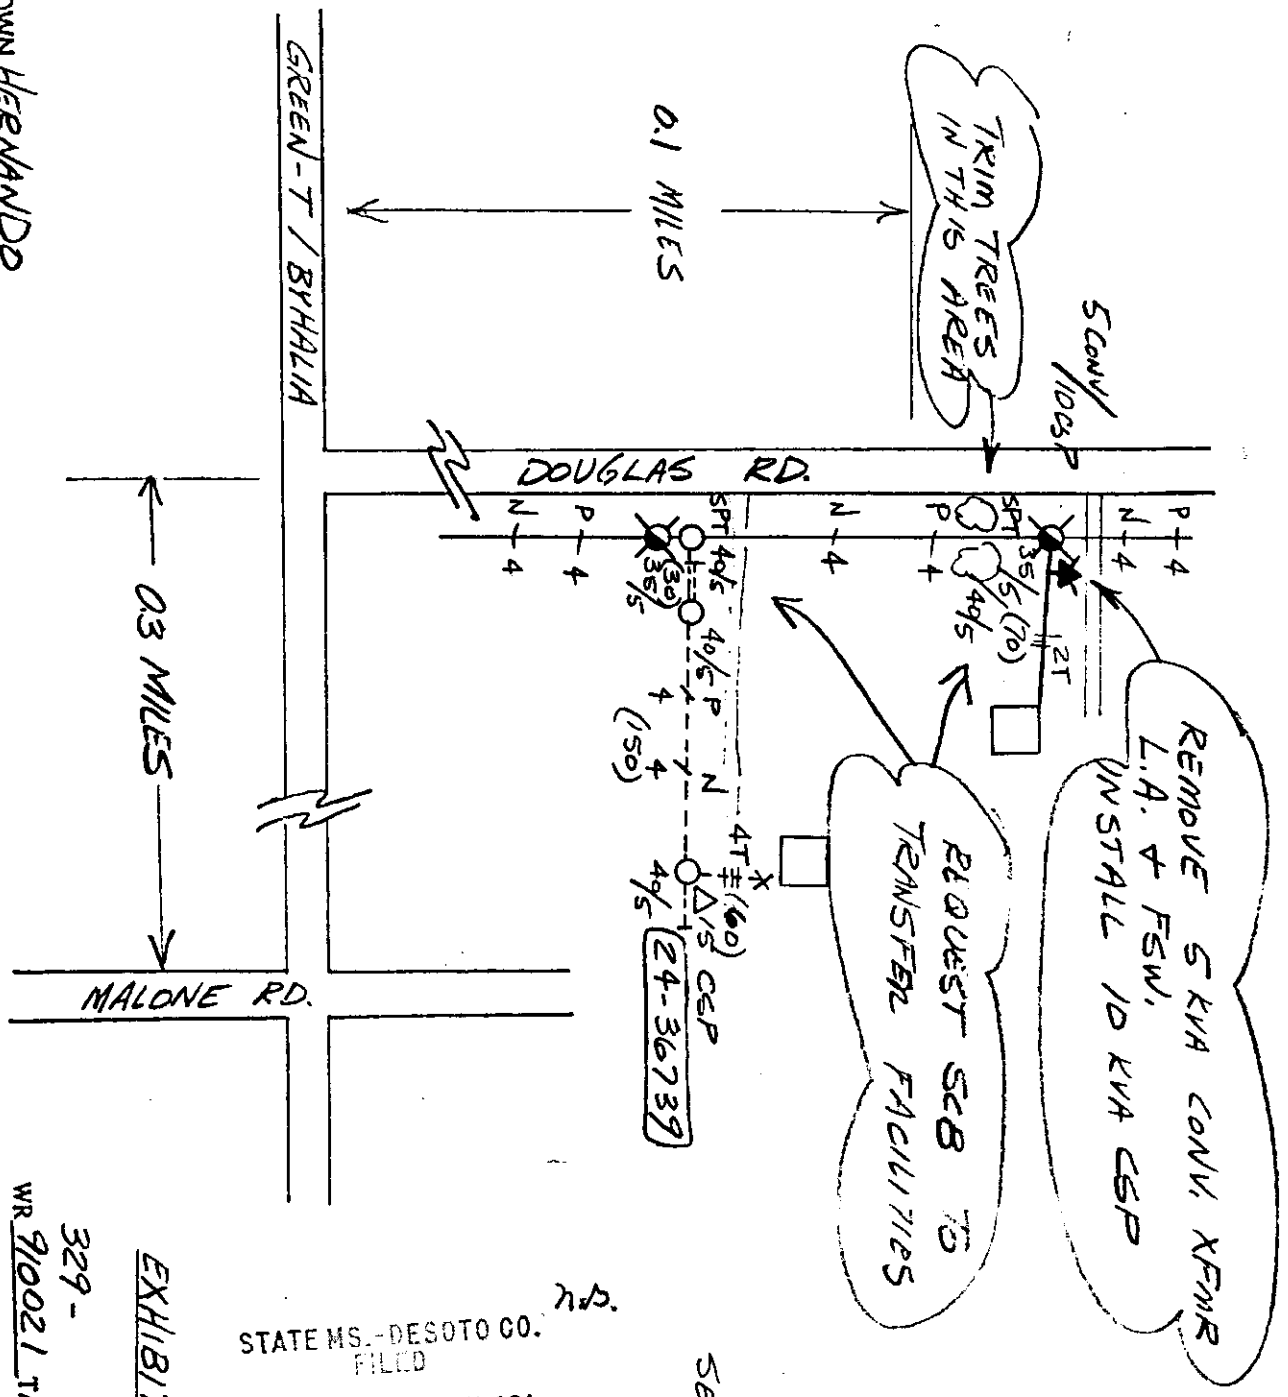

NEAREST TOWN HERNANDO
CATEGORY SR/GRAVEL ROAD
SITE CONDITIONS 2 DAYS DRY
LOCATE # _____
DATE LOC. AVAIL. _____

VICINITY MAP ATTACHED
24-36739

SE 1/4, SECTION 34
T2S, R7W
DESO TO

STATE MS.-DESO TO CO.
FILED
Nov 4 1 09 PM '91
RECORDED 11-5-91
DEED BOOK 239
PAGE 604
W.E. DAVIS CH. CLK.

EXHIBIT "A"

329 -
WR 910021 TAX AREA 62358
TITLE SERVICE TO 160
DOUGLAS RD-BAINES RES.
DESIGNER DAVID DENT
DATE 7-22-91 SCALE N.T.S.